




PRESSURELUBE
INTERNATIONAL

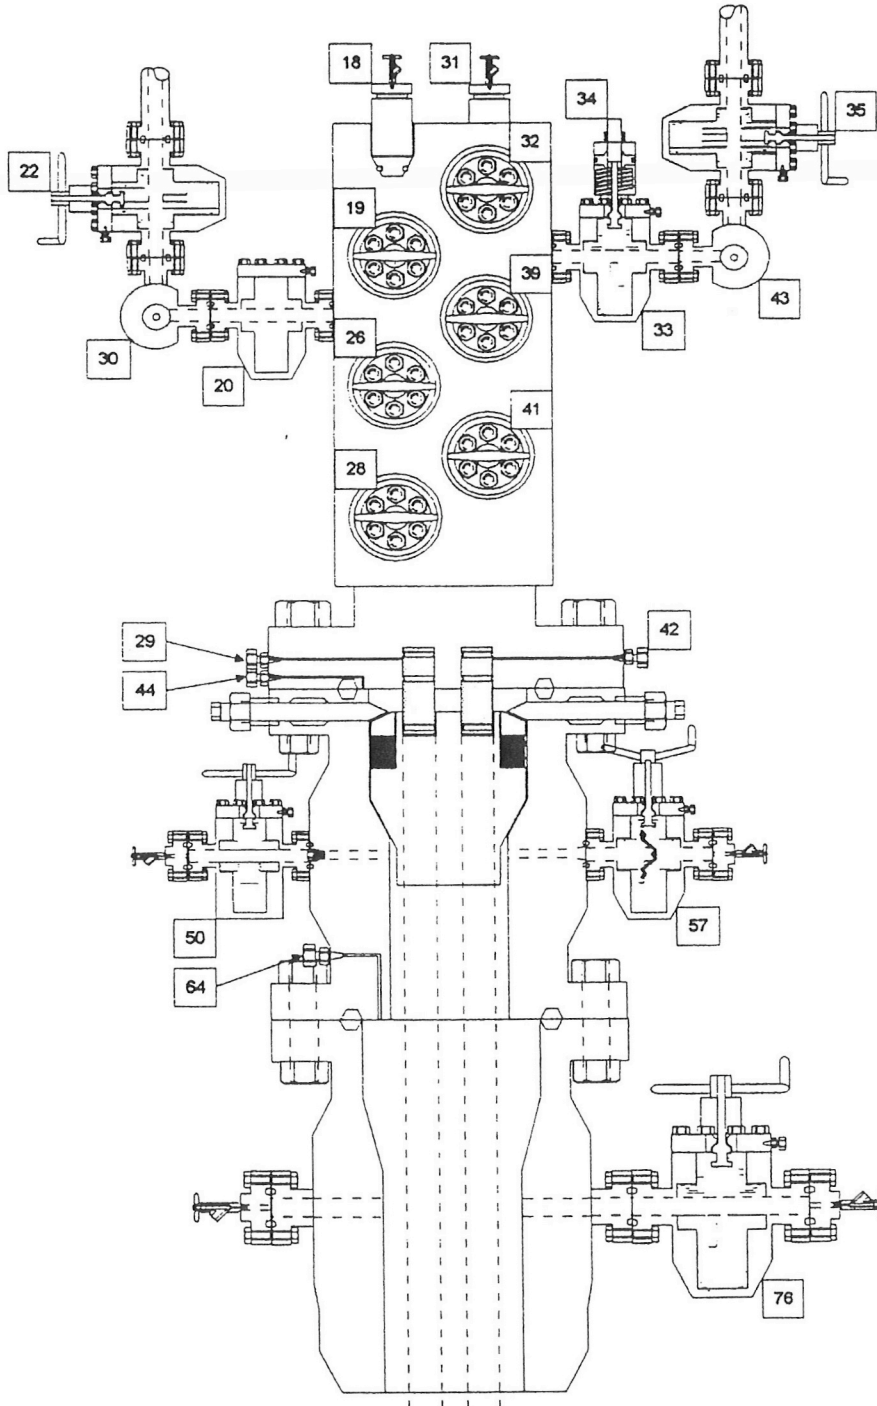

CONTRACTOR Pressure Lube International	DRAWN BY	INITIALS	DATE 6 December 97	DESCRIPTION Wellhead As Built
OPERATOR	APPROVED BY	INITIALS	SCALE NOT TO SCALE	TITLE IS - 023